Distributed by:

JAMECO® ELECTRONICS

www.Jameco.com ✦ 1-800-831-4242

The content and copyrights of the attached material are the property of its owner.

DT\DT-128

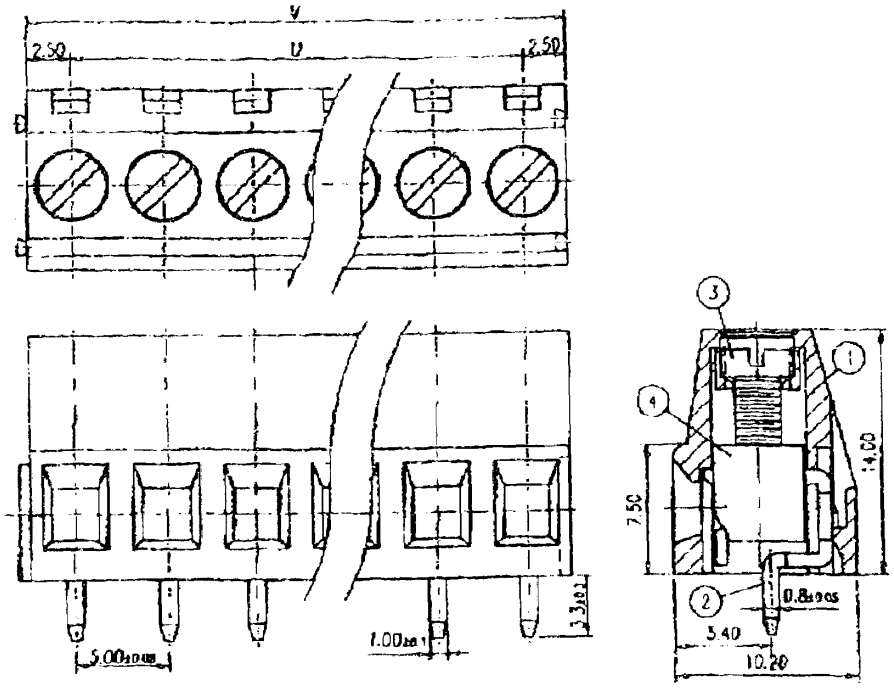

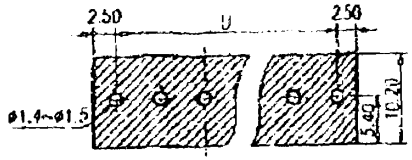

P.C.B. LAYOUT(R2/P)

Jameco Part Number 99397

P	3	5	4	5	6	7	8	9	10	11	12	13	14	15	16
U	5.0	10.0	15.0	20.0	25.0	30.0	35.0	40.0	45.0	50.0	55.0	60.0	65.0	70.0	75.0
V	10.0	15.0	20.0	25.0	30.0	35.0	40.0	45.0	50.0	55.0	60.0	65.0	70.0	75.0	80.0
P	17	18	19	20	21	22	23	24	25	26	27	28	29	30	31
U	80.0	85.0	90.0	95.0	100.0	105.0	110.0	115.0	120.0	125.0	130.0	135.0	140.0	145.0	150.0
V	85.0	90.0	95.0	100.0	105.0	110.0	115.0	120.0	125.0	130.0	135.0	140.0	145.0	150.0	155.0

Tolerances For PITCH ERROR

NOTES:

△10A

1. Rating: 300V 10A(IEC 250V ~~22Ac~~)
   PITCH: 5.00mm
2. Insulation Withstands Voltage:
   AC 2000V/MIN
3. Insulation Resistance:
   500MΩ or more at DC500V
4. Using Temperature Range:
   -40°C~+105°C
5. Screw Torque Value: 4 kg-cm (MAX)
6. Suitable Electric Wire:
   AWG ~~22~~~~-30~~ 24~12 (IEC 0.5~2.5mm²) △
7. Undimensioned Tolerances:

⊥	//	≡	±0.1/10
PITCH ERROR			±0.05/10
~~DIMENSIONAL TOLERANCES~~			±0.3

REV.	CONTENT	CHK.	DATE
△	工程変更	DRWG	01.04.03

ITEM	NAME OF PART	NO. OF PART	Q'TY	MATERIAL	NOTES
4	WIRE CAGE	XCXXXXXCH00	P	STEEL	Zn Plated
3	SCREW	SD0000.1400	P	STEEL	M3.5/2± Plated
2	SOLDER PIN	0013B00100	P	COPPER	Tin Plated
1	HOUSING	(0015A00000	1	PA66(V2)	GREEN

DWG.	林浚宏	DATE	1998.12.28	UNITS	MM	SHEET/OF	1/1
CHK.	吳	DATE		SCALE	4:1 ( )		
APP.	[redacted]	DATE		NAME	DT-128V-□□P		
[redacted]				DRG NO.	SP-02-128VP000		